


1
141
PROPOSED GROUND FLOOR RCP
1 : 100

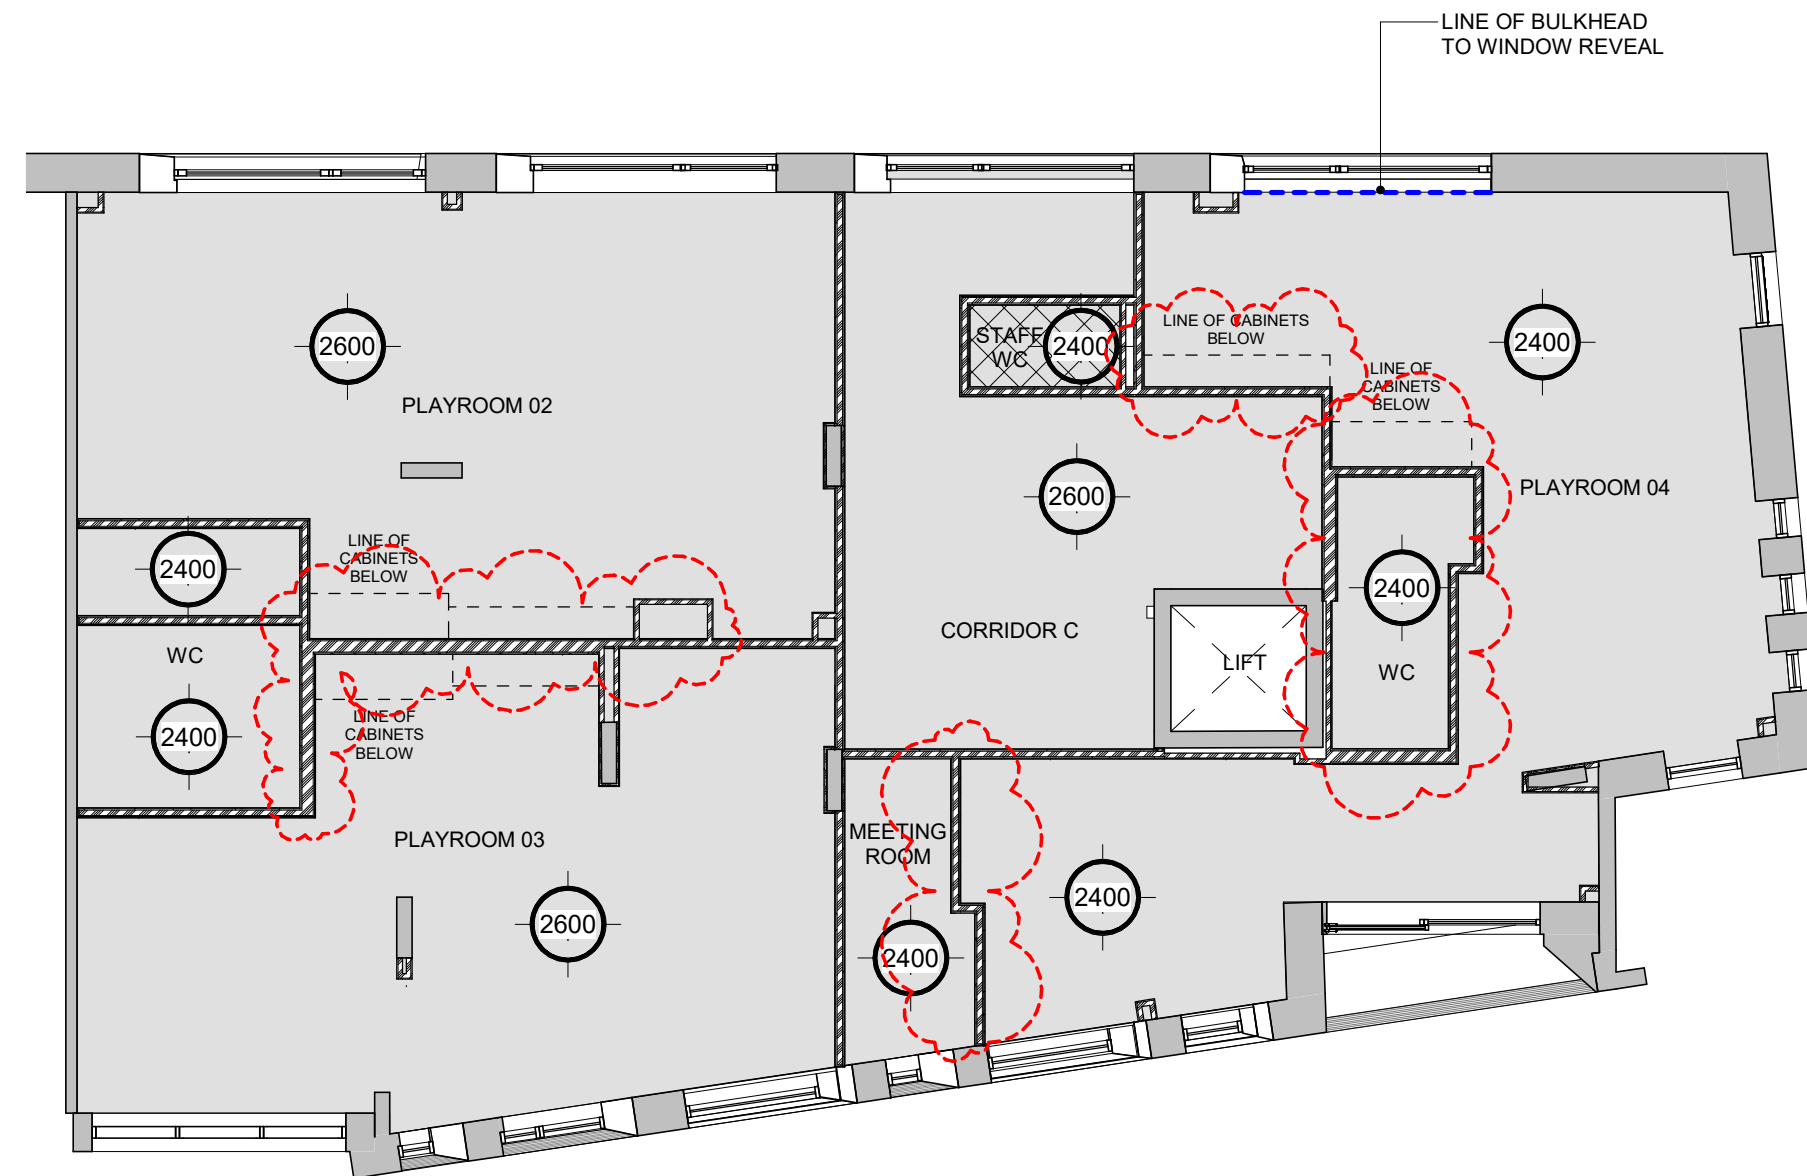

2
141
PROPOSED FIRST FLOOR RCP
1 : 100

NOTE: EXISTING STRUCTURAL SOFFIT LEVEL TO ALL FLOORS TO BE VERIFIED ON SITE.

CEILING LEGEND	
	EXPOSED SOFFIT TO REMAIN. ALLOWANCE TO BE MADE FOR SPRAYING SOFFIT. FINISH REF: WHITE. (PENDING REVIEW OF SOFFIT CONDITION)
	PLASTERBOARD CEILING ON CONCEALED M.F. SYSTEM. 1 LAYER 12.5mm WALLBOARD. PLASTERBOARD TO BE PAINTED WITH 1no. UNDERCOAT & 2no. FULL COATS DULUX TRADE ECOSURE. COLOUR: BRILLIANT WHITE, RAL 9016
	PLASTERBOARD CEILING AS ABOVE WITH 100 ISOVER INSULATION LAID OVER CEILING AS ACOUSTIC BARRIER
	LINE OF BULKHEAD
	INDICATES HEIGHT OF CEILING

DO NOT SCALE FROM THIS DRAWING.
ALL DIMENSIONS TO BE CHECKED ON SITE.
COPYRIGHT PROTECTED.

TENDER

NOTE:
INFORMATION BASED ON RECORD DRAWINGS PROVIDED BY OTHERS. SUBJECT TO SITE SURVEY. ARCHITECT TO BE IMMEDIATELY ADVISED OF ANY DISCREPANCIES.

REV	DATE	DESCRIPTION	DRAWN	CHKD
02	29.08.23	Updated to suit latest GA revisions. Issued for Tender	TC	JFM
01	09.08.23	Updated to latest GA. Ceiling heights lowered to rooms to suit M&E comments	TC	JFM



NURSERY LOCATION
GREENWICH MV
COUNTRY
ENGLAND
PROJECT
**N FAMILY CLUB
NEW NURSERY**

DRAWING
**PROPOSED ALL FLOORS
RCP**

CONSULTANT
LEWIS AND HICKEY
DISCIPLINE DESCRIPTION
ARCHITECTURE

18 Farnham Road
Guildford
Surrey
GU1 4XA

Tel: 01483 560908
Fax: 01483 560660
Email: guildford@lewishickey.com

SCALE	PAPER SIZE	DATE	DRAWN	CHECKED
As indicated	A2	01.08.23	TC	JFM

PROJECT No.	DISCIPLINE CODE	DRAWING No.
GMV001	A	141

CONSULTANT PROJECT No.	STATUS	REVISION
G4752	T	02